


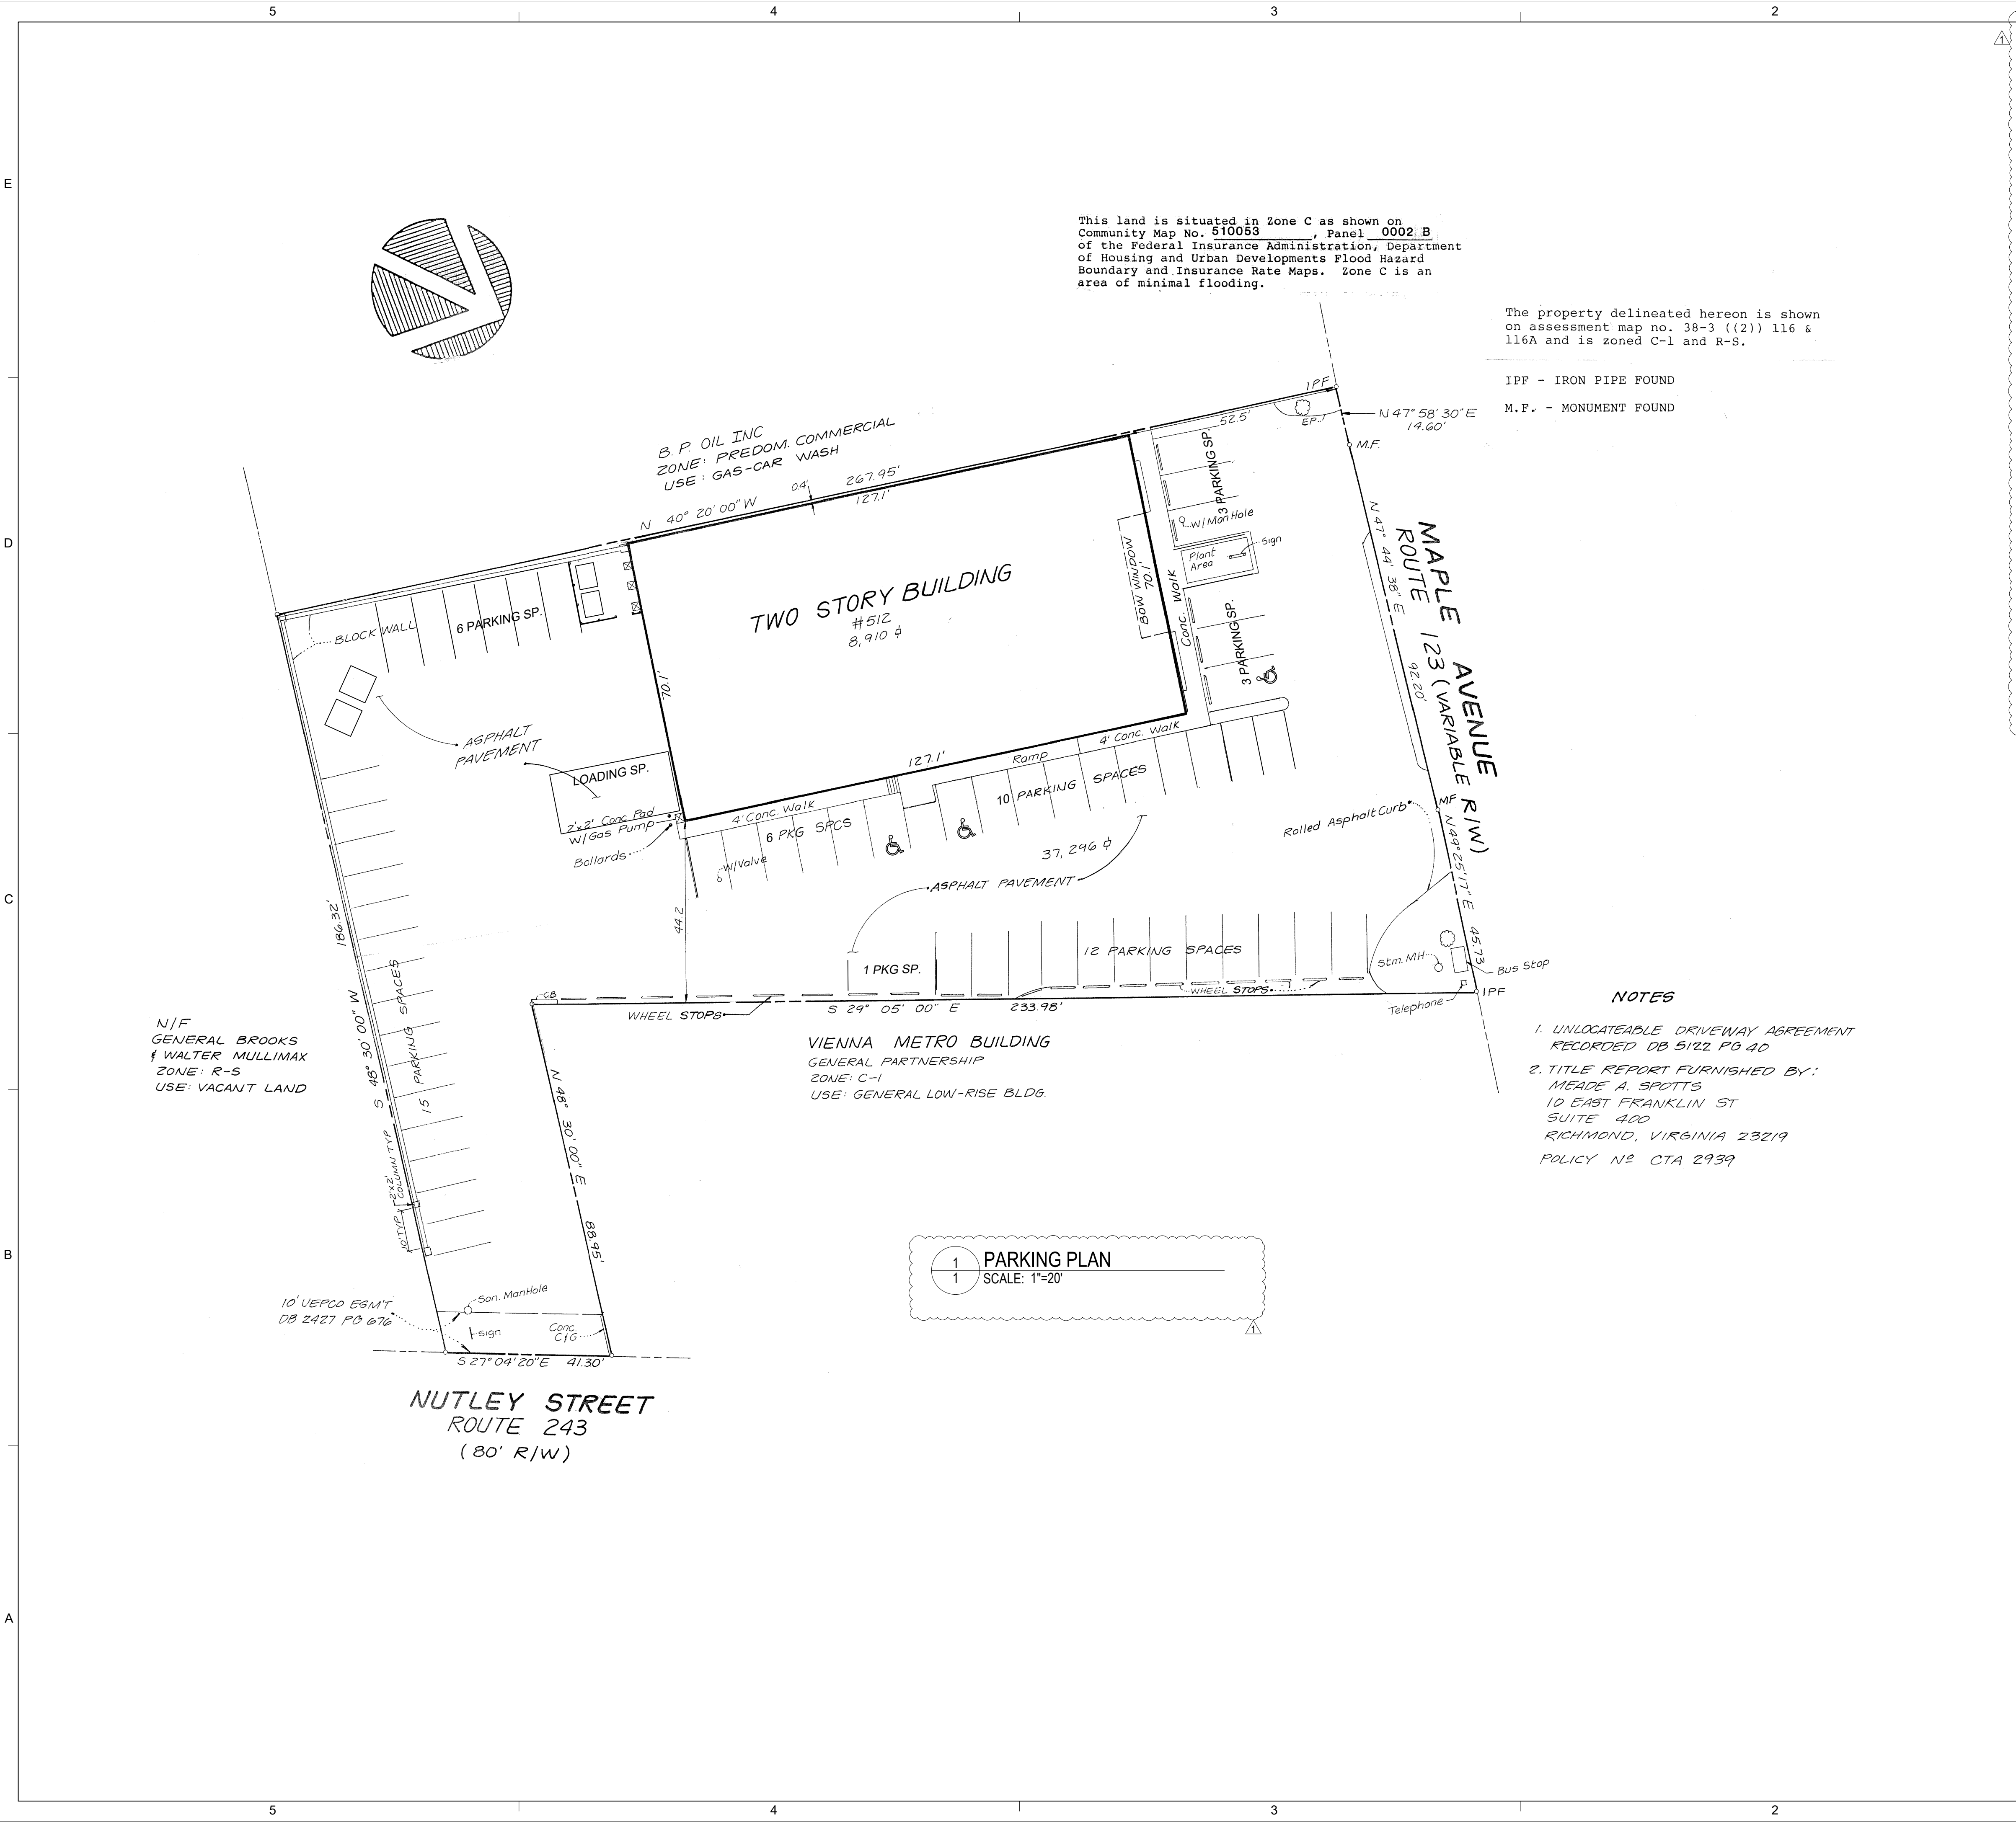

PARKING TABULATIONS

BUILDING AREA	SUITE AREA (SF)	PARKING REQUIREMENTS	REQ'D. PKG.
GROUND LEVEL TENANT AREAS			
TENANT SPACE A/B- GROCERY USE	924	4 SP/ 1000 SF	4 SP
TENANT SPACE A/B- RESTAURANT USE	2,540	1 SP/ 4 SEATS	48 SEATS= 12 SP see footnote 1
TENANT SPACE C- QUANTUM MOVEMENT	4,350	see footnote 2	11 SP
SECOND LEVEL TENANT AREAS			
SPACE 200- BUSINESS USE (VACANT)	2,735	1 SP/ 200 SF	14 SP see footnote 3
SPACE 201- SPECIALIZED INSTRUCTION (ZERKALO)	2,452	see footnote 4	5 SP
SPACE 202- SPECIALIZED INSTRUCTION (THE LAB)	1,838	1 SP/ 200 SF	9 SP see footnote 5

- footnote 1 hours of operation (7 days a week) 8am-8pm
- footnote 2 Indoor Recreational Use, Private (Athlete Performance and Training Facility)
4 employees max. per shift; 10 clients max. at any one time
Parking @ 1 space per employee on max. shift + 2 spaces per 3 clients = 11 spaces
Hours of operation (7 days a week) 8am-9pm
staff only (7 days a week) 8am-9pm
performance and training appointments (7 days a week) 6pm-9pm
- footnote 3 General Business- anticipated hours of operation (M-F) 9am-5pm
- footnote 4 Specialized Instruction- Musical Theatrical Arts for children 6yrs-17yrs of age
2 employees per max. shift; 8 students max. on site at any one time (primarily parent drop off & pick up)
2 employees per max shift @ 2 spaces per each 3 employees = 1 spaces
+ sufficient number of spaces to accommodate all persons anticipated to be on-site at any one time
8 students @ 1 space per 2 students = 4 spaces
Hours of operation (M-F) 4pm-10pm
Hours of operation (Sa) 9am-10pm
- footnote 5 Hours of operation (M,Tu,W,F) 5pm-7pm
Hours of operation (Sa-Su) 9am-1pm

TIME PERIOD	TENANT	MON	TUES	WED	THUR	FRI	SAT	SUN
8AM-5PM	SPACE A/B	16 SP	16 SP	16 SP	16 SP	16 SP	16 SP	16 SP
	SPACE C	11 SP	11 SP	11 SP	11 SP	11 SP	11 SP	11 SP
	SPACE 200	14 SP	14 SP	14 SP	14 SP	0 SP	0 SP	0 SP
	SPACE 201	6 SP	6 SP	6 SP	6 SP	6 SP	6 SP	6 SP
	SPACE 202	9 SP	9 SP	9 SP	9 SP	9 SP	9 SP	9 SP

TOTAL	56 SP	56 SP	56 SP	56 SP	56 SP	42 SP	42 SP	
TOTAL PARKING SPACES REQUIRED = 56 SPACES								
TOTAL PARKING SPACES PROVIDED= 56 SPACES								
53 STANDARD PARKING SPACES								
3 ACCESSIBLE PARKING SPACES								
+ 1 LOADING SPACE								

THIS PARKING PLAN IS BASED ON A MARCH 1, 1989 SURVEY THAT WAS PREPARED BY HAROLD A. LOGAN ASSOC., PC

UPDATED INFORMATION & PARKING TABULATION HAS BEEN PREPARED BY ROBERT DUNNING, AIA

DunningGroup
architects

a professional limited liability company

14420 Albemarle Point Place, Suite 230
Chantilly, Virginia 20151

703.378.7991
www.dunningarchitects.com

PROJECT:

PARKING PLAN

at
512 Maple Ave. W.,
Vienna, VA 22180

DEVELOPER:

CONSULTANTS:

PROFESSIONAL SEAL:

ISSUED: DATE:
PERMIT FEBRUARY 27, 2026

NO. REVISION: DATE:
REVIEW COMMENTS MARCH 2, 2026

DESIGNED/DRAWN BY: ND, RPD
REVIEWED/APPROVED BY: RPD
PROJECT NO: 2025-060
SCALE: AS NOTED

THE DOCUMENT AND IDEAS AND DESIGNS INCORPORATED HEREIN AS AN INSTRUMENT OF PROFESSIONAL SERVICE, IS THE PROPERTY OF DUNNING GROUP ARCHITECTS, LLC AND IS NOT TO BE COPIED OR USED, IN WHOLE OR IN PART FOR ANY OTHER PROJECT WITHOUT THE WRITTEN AUTHORIZATION OF DUNNING GROUP ARCHITECTS, LLC.

SHEET TITLE:

PARKING PLAN

SHEET NUMBER:
1 OF 1