


F:\Jobs\121004 - Vienna Assembly of God\121004_A1 SITE PLAN.dwg, 7/16/2021 9:21:24 AM, AutoCAD PDF (High Quality Print).pc3

CENTER STREET N.

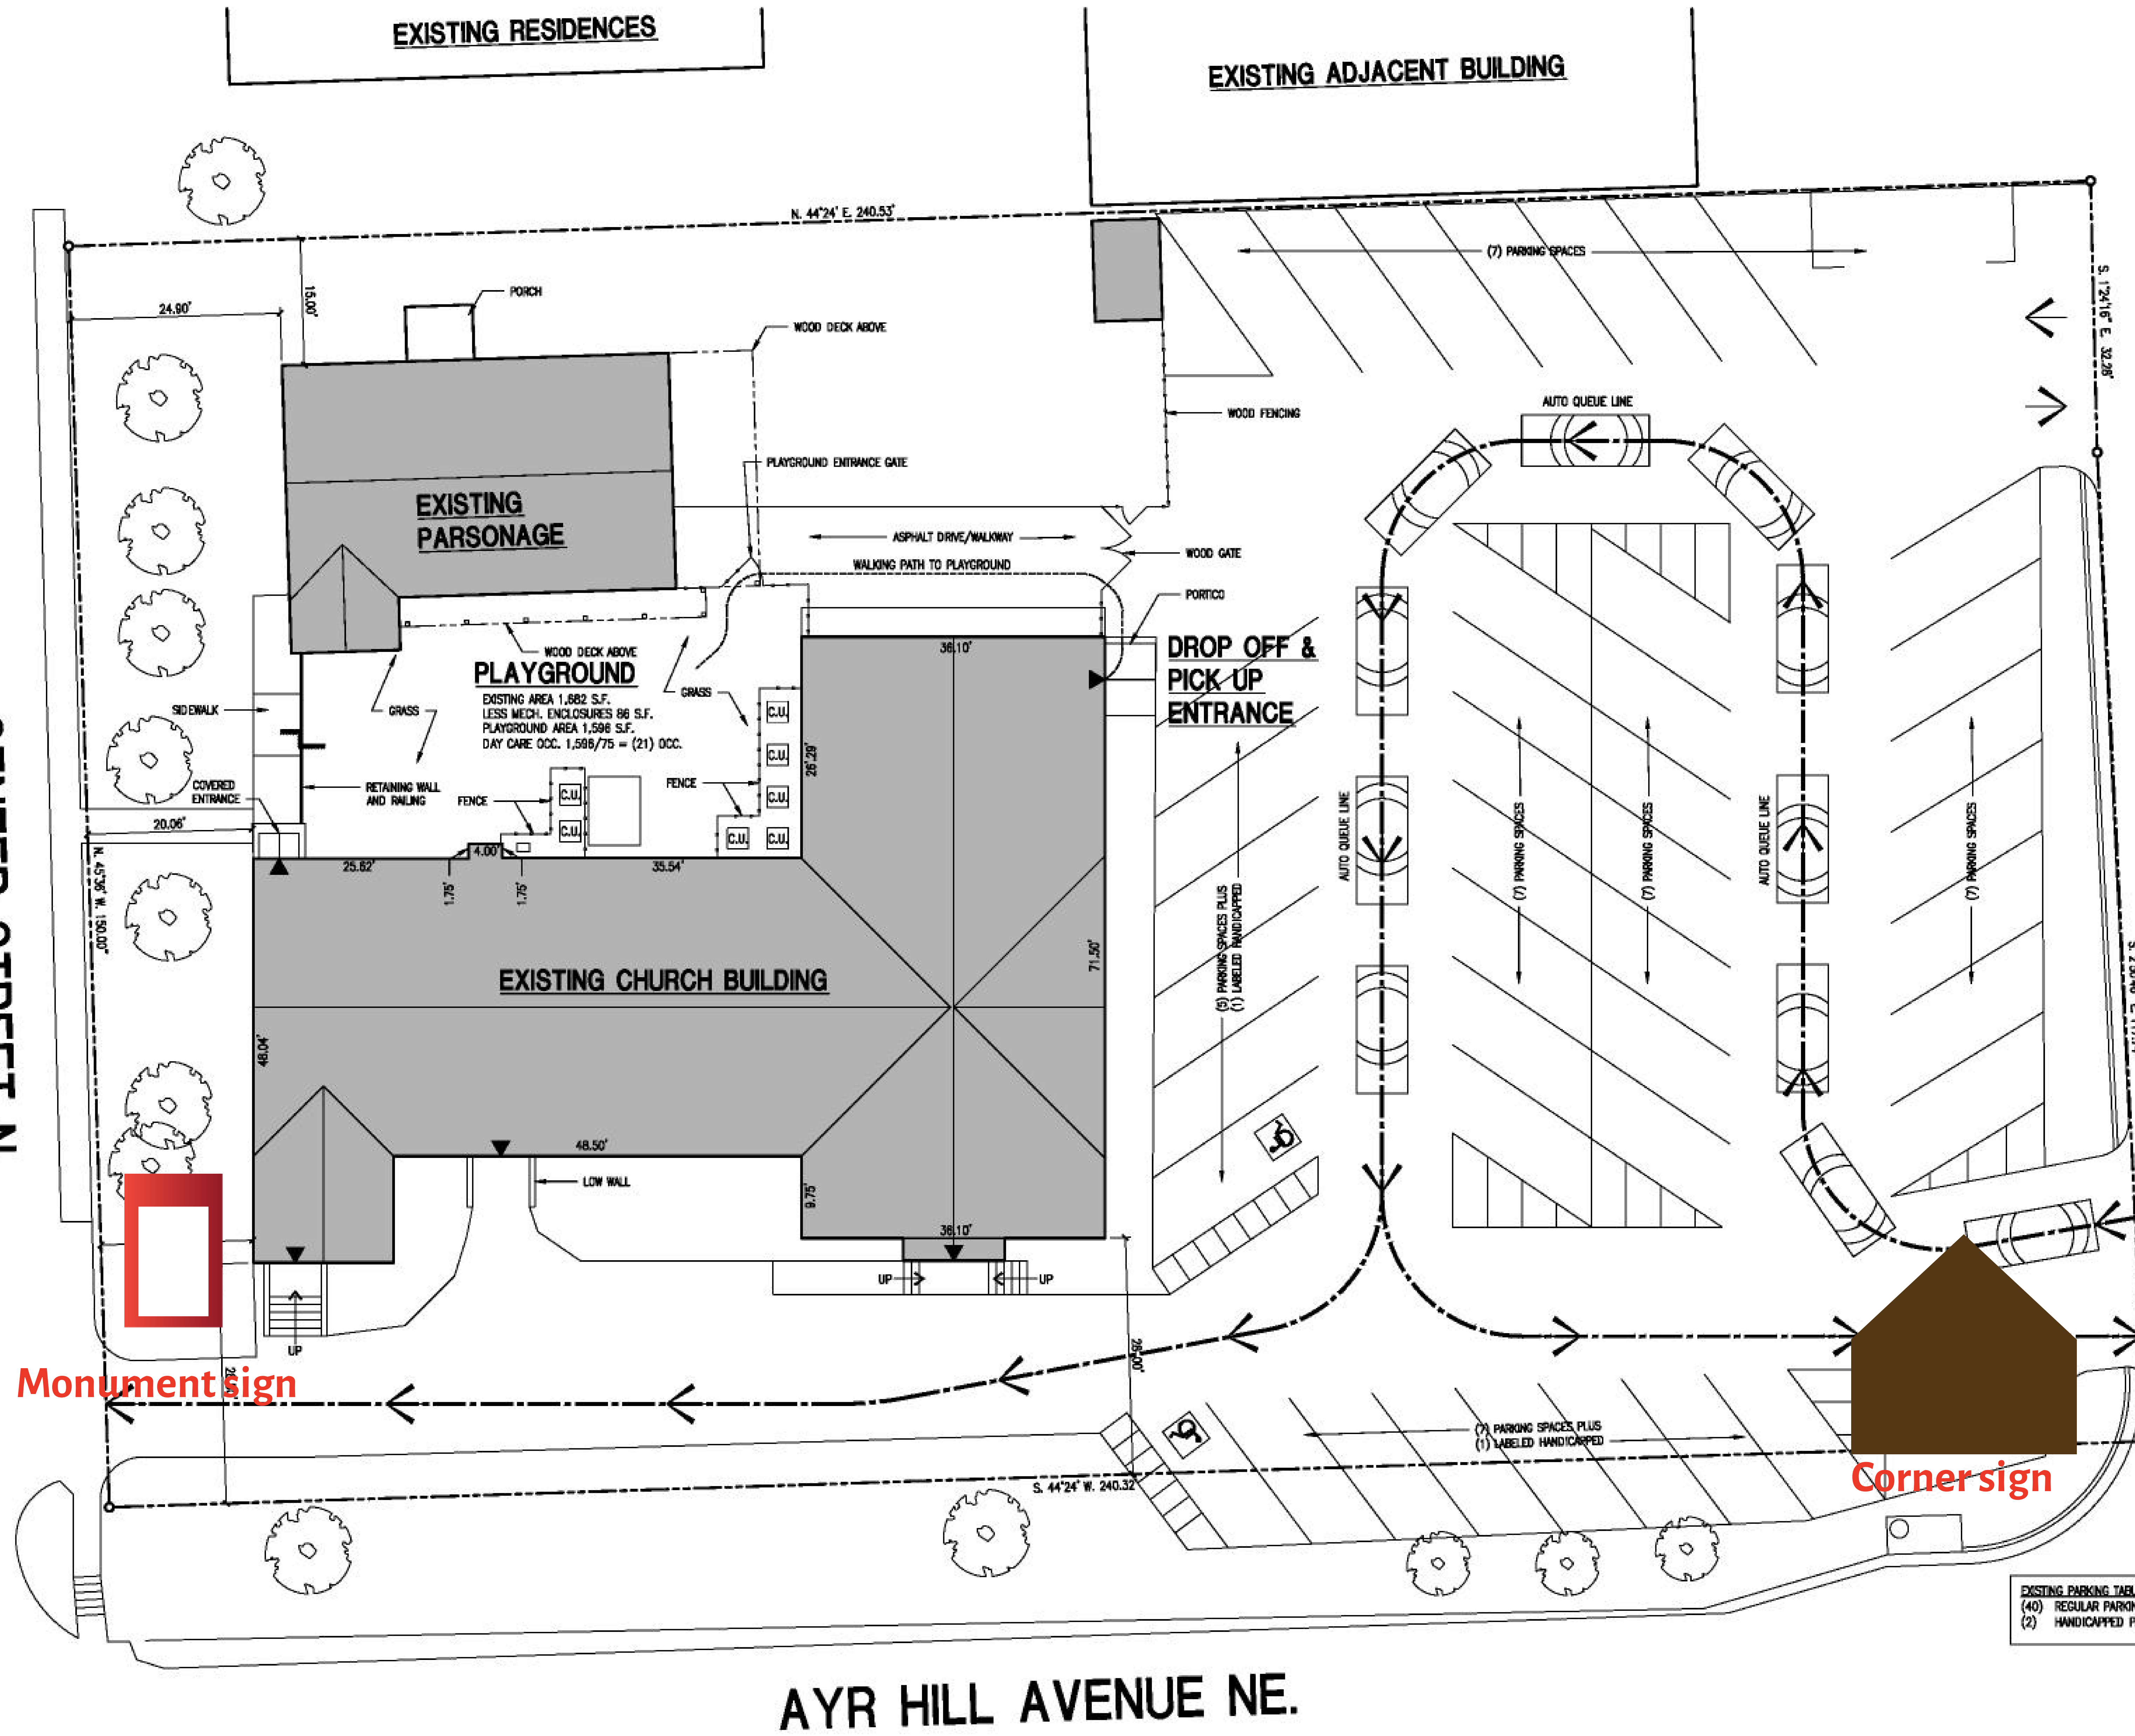

1 ARCHITECTURAL SITE PLAN (EXISTING CONDITIONS)
A1 SCALE 1" = 10'

DOMINION ROAD NE.

Attachment 03



2911 Hunter Mill Road, Suite 201
Oakton, Virginia 22124
(703) 556-0700

111 West Washington Street
Charles Town, West Virginia 25414
(304) 725-2255

www.hlrarchitects.com

Seal
Digitally signed
by John J.
Recny
Date:
2021.07.17
07:20:27 -04'00'

Consultant

Key Plan

Project Name and Address

VIENNA ASSEMBLY
OF GOD CHURCH

100 Ayr Hill Avenue NE
Vienna, VA. 22180

Drawing Name

ARCHITECTURAL
SITE PLAN
(EXISTING CONDITIONS)

Date 7/16/21 PERMIT

Revisions

Date Description

Date	Description

Project Number

121004x County

Drawing Number

APPROVED

07/16/21 Permit#212010163
Building Plan Review